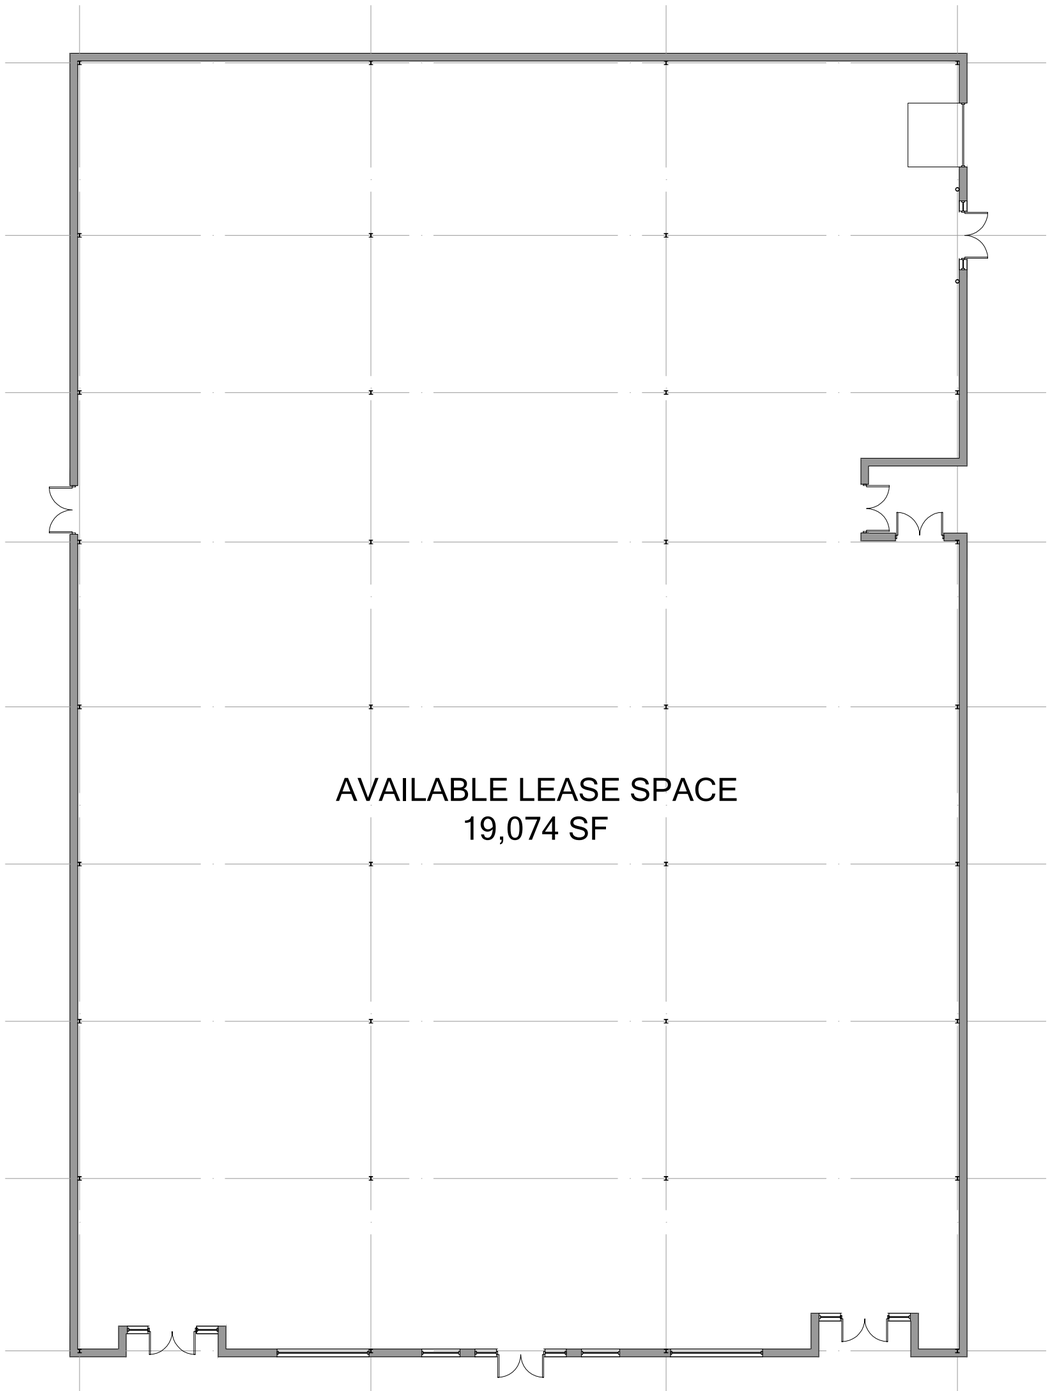

01 LEASABLE SF FLOOR PLAN

Scale: 1/16" = 1'-0"

0 8' 16' 32'

Good Fulton & Farrell Architects
2808 Fairmount Street
Suite 300
Dallas, Texas 75201
214.303.1500/Tel
214.303.1512/Fax
www.gff.com

© Good Fulton & Farrell 2008

1616 HI LINE
DALLAS, TEXAS 75207
AS-BUILTS

No.	Date	Item

REVISIONS

JWW
Drawn

JWW/BEM
Checked

JWW/BEM
Approved

THIS DOCUMENT IS NOT FOR REGULATORY APPROVAL, PERMITTING, OR CONSTRUCTION.

ARCHITECT/INTERIOR DESIGNER'S NAME

LEASABLE SF

Project No. 08157.05
Date 02.03.09

A2.01